

Pump

PERMIT NUMBER **06978**

GRANVILLE-VANCE DISTRICT HEALTH DEPARTMENT
IMPROVEMENT AND OPERATION PERMITS

Zoning #
16940

COUNTY:	TAX NO.	TYPE OF ESTABLISHMENTS			*THIS PERMIT SHALL BE ACCOMPANIED BY A LAYOUT SHOWN ON A PLAT, INCLUDING SYSTEM REQUIREMENTS. *THIS IMPROVEMENT PERMIT IS SUBJECT TO REVOCATION IF THE INTENDED USES CHANGE FROM THOSE SHOWN ON THE IMPROVEMENT PERMIT CHANGES SHALL REQUIRE HEALTH DEPARTMENT APPROVAL.
<u>Granville</u>	<u>191604721585</u>	RESIDENCE <input checked="" type="checkbox"/>	NUMBER OF BEDROOMS:	NUMBER OF OCCUPANTS:	
OWNER:	SR. NO.	BUSINESS <input type="checkbox"/>	<u>3</u>	<u>6 maximum</u>	
<u>Andre Glasgow</u>		OTHER <input type="checkbox"/>	WATER SUPPLY	OTHER <input type="checkbox"/>	
APPLICANT'S ADDRESS:		WELL <input checked="" type="checkbox"/>	PUBLIC <input type="checkbox"/>		
<u>7683 Sam Young Rd.</u>		TYPE OF WASTEWATER SYSTEM	INITIAL INSTALLATION	REPAIR	
<u>Oxford, NC 27565</u>		DESIGN FLOW:	<u>Type III b,g</u>	<u>Type III b,g</u>	
PROPERTY ADDRESS/LOCATION:		LTAR:	<u>360 gpd</u>		
<u>Henry Wilson Rd</u>		ABSORPTION AREA:	<u>.2 gpd/ft²</u>		
SUBDIVISION:		TRENCH WIDTH:	<u>1800 ft²</u>		
<u>Rocky Ridge</u>		TRENCH DEPTH:	<u>3'</u>		
LOT NUMBER:		TRENCH SPACING:	<u>18"</u>		
<u>1</u>		TOTAL TRENCH LENGTH:	<u>9'0.c.</u>		
REFERENCE SKETCH (SEE PLAT FOR DETAILS)		NUMBER OF TRENCHES:	<u>450'</u>		
<u>Dig lines level and on contour</u>		GRAVEL DEPTH:	<u>6</u>		
<u>Keep trench depth at 18"</u>		TANK SIZE:	<u>Accepted Status (non-gravel)</u>	PERMIT VALID FOR: 5 YEARS	
<u>Call for system lay-out 693-2688</u>		PUMP TANK SIZE:	<u>1000 gal</u>	<input checked="" type="radio"/> YES <input type="radio"/> NO	
<u>be careful clearing trees</u>		DISTRIBUTION DEVICE:	<u>1000 gal</u>	NO EXPIRATION	
			<u>pressure manifold</u>	<input checked="" type="radio"/> YES <input type="radio"/> NO	


→ Dig lines level and on contour
→ Keep trench depth at 18"
→ Call for system lay-out 693-2688
→ be careful clearing trees

IMPROVEMENT PERMIT DATE: 1-14-2011
FOR: Andre Glasgow
ISSUED BY: David Cumbee

CONSTRUCTION AUTHORIZATION FOR IMPROVEMENT PERMIT # 6978
Unless otherwise indicated, the same conditions above apply regarding system type, layout, location and installation requirements.
(The wastewater system cannot be installed until authorization is signed)
Comments: Site visit by Health Dept. mandatory prior to installation

Date: 1-14-11 Environmental Health Specialist: David Cumbee
Construction Authorization Addendum Yes No

OPERATION PERMIT DATE:
SYSTEM INSTALLED BY:
ISSUED BY:
PERFORMANCE, MONITORING, MAINTENANCE AND OPERATION AS REQUIRED BY RULE .1961

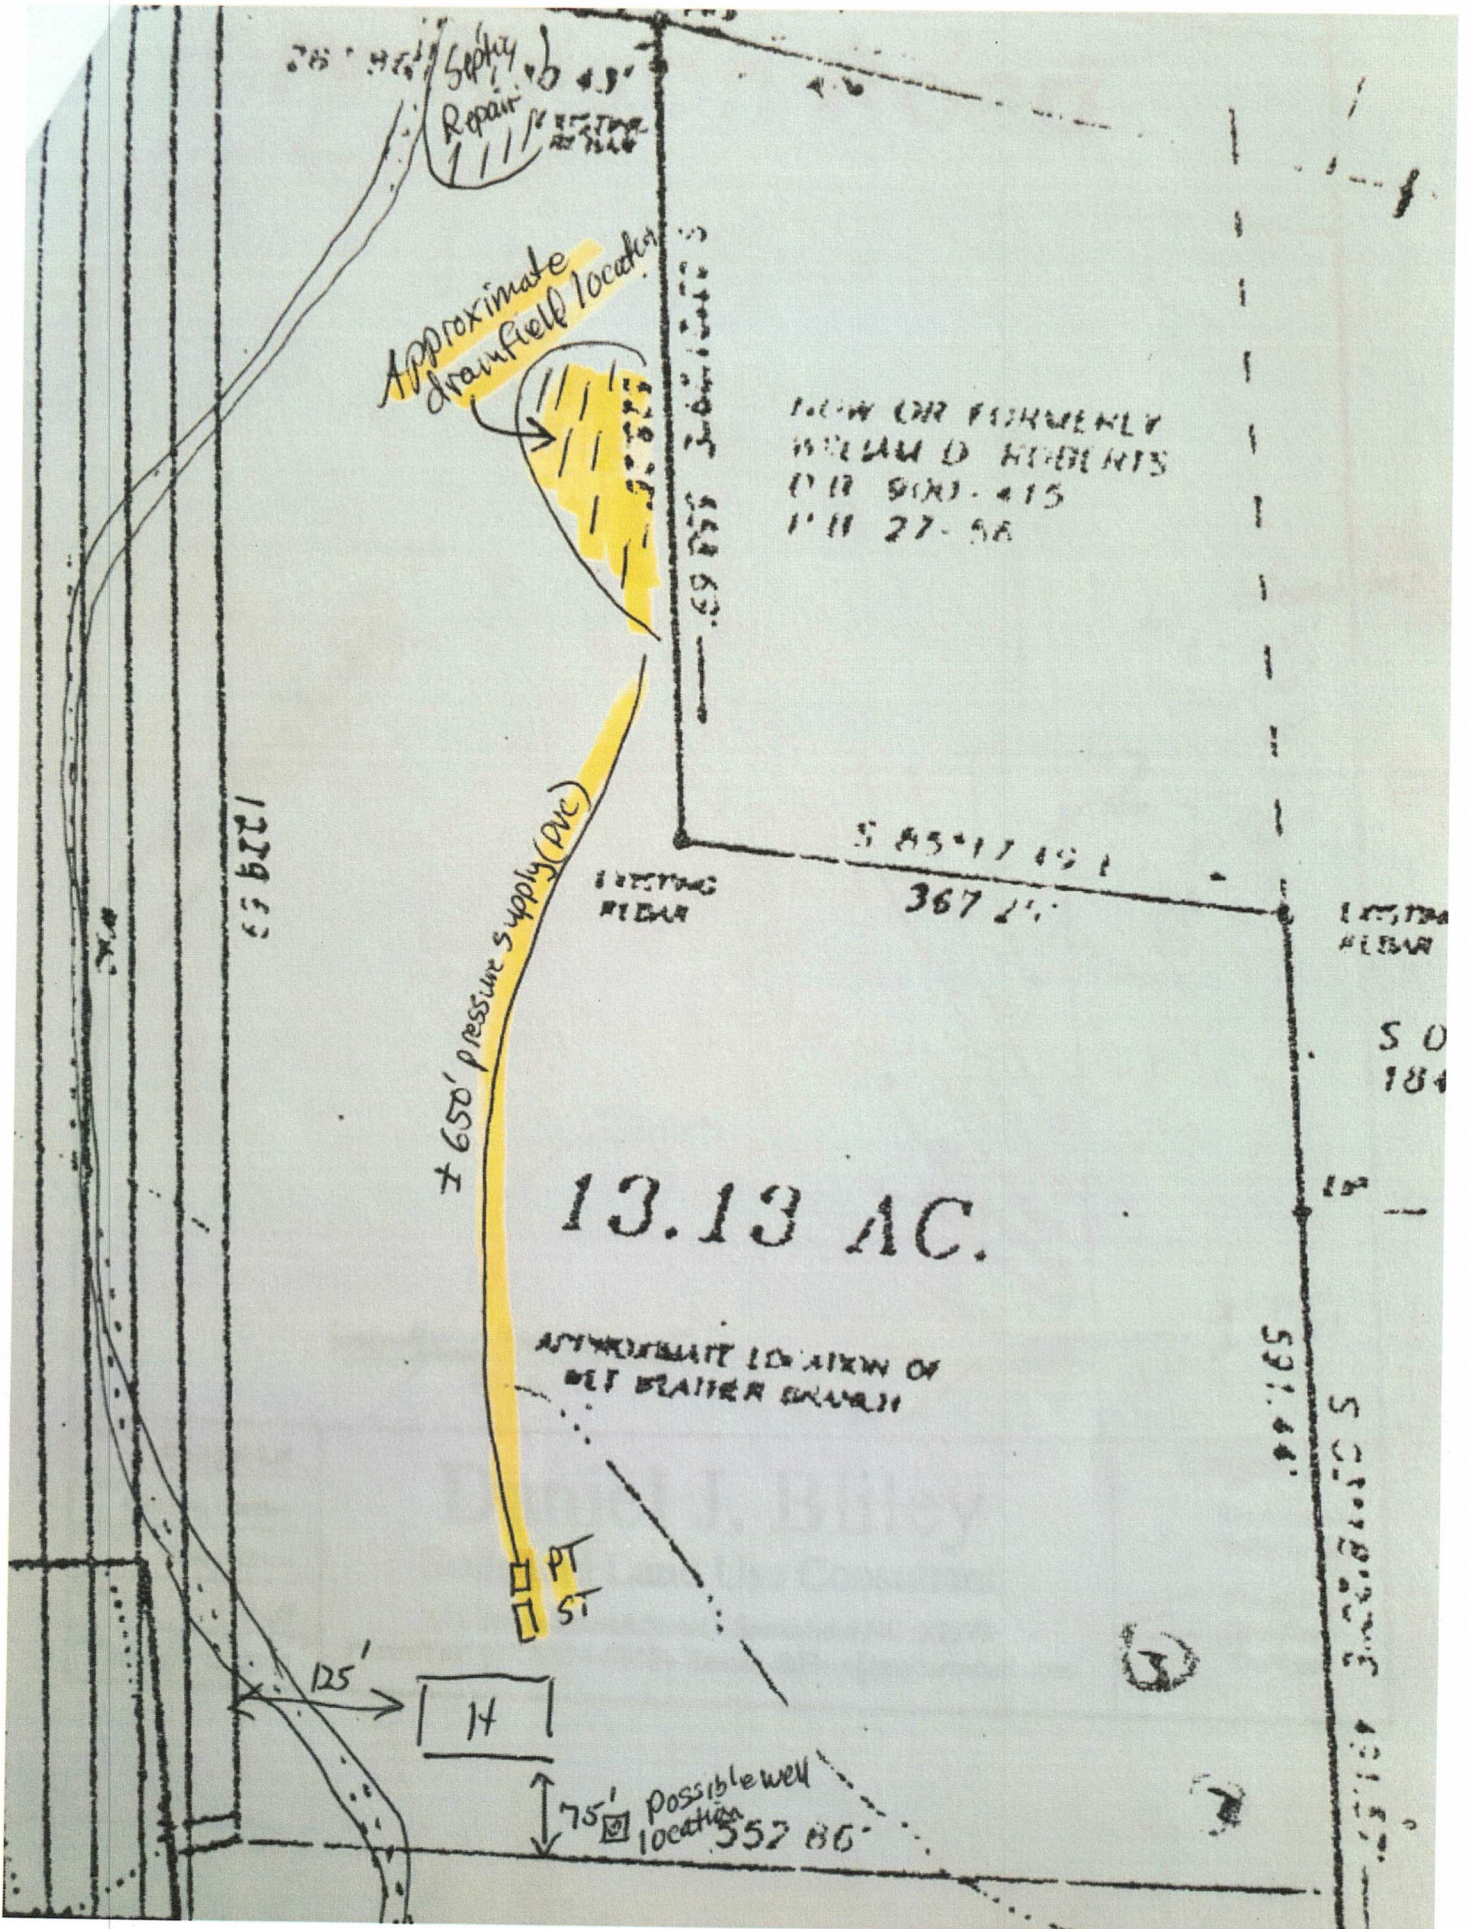

SOIL SCIENTISTS

Allison Soil Consultants, Inc.
 Charles M. Allison, Jr.
 830 Leesville Road
 Lynchburg, VA 24502
 804-237-4523
 fax 804-237-8832

Appian Consulting Engineers, VA
 P.O. Box 7966
 Rocky Mount, NC 27804
 252-972-7703
 fax 252-972-7638

Daniel J. Bliley
 614 South Second St.
 Smithfield, NC 27577
 919-934-8610 Phone & Fax
 mobile 919-612-3539

Chandler Soil Consultants, Inc.
 600 South Churton St. Ste 93
 Hillsboro, NC 27268
 919-732-8169

John Davis
 Soil Horizons
 P.O. Box 1063
 Youngsville, NC 27596
 919-554-2363

Michael D. Eaker
 Southeastern Soil & Environmental
 P.O. Box 9321
 Fayetteville, NC 28311-7696
 910-822-4540

Neal Floyd
 919-870-7865
 fax 919-676-8395
 pager 919-505-8858

Central Carolina Soil Consulting
 63259 Falls of Neuse Road
 P.M.B. 341 Jason Hall
 Raleigh, NC 27615-6809
 919-790-1083 cell# 919-625-5948

Dwyane A. Graham
 P.O. Box 521
 Warsaw, NC 28398
 910-893-8743

Kelly Environmental
 Harold Kelly
 Clayton Avenue
 Roxboro, NC 27574
 Cell 336-598-2382
 Home 336-322-4724

Hal Owen & Associates, Inc.
 Soil & Environmental Consultant
 P.O. Box 400
 266 Old Coats Road
 Lillington, NC 27546
 910-893-8743

Fred Smith
 4729 Sykes Road
 Nashville, NC 27856
 252-459-7798

Soil & Environmental Consultants
 244 West Millbrook Road
 Raleigh, NC 27609
 919-846-5900
 fax 919-846-9467

AWT
 Jeff Vaughan
 5400 Etta Burke Court
 Raleigh, NC 27606
 919-859-0669 fax# 919-233-1970

Karl Shaffer, L.S.S.
 685 Sanford Road
 Pittsboro, NC 27312
 (919) 542-5803 office
 (919) 244-1984 cell

Soil Services
 Sarah Wheeler
 919-896-1607