


**Environmental Health Section  
Alamance County Health Department  
(336) 570-6367**

Name: Backwoods Land LLC Tax Map #: 11-3-14  
Subdivision: Uplands NW Lot#: 1  
IP: X AWC: OP: WELL: X  
EHS: RES Date: 3/27/2023

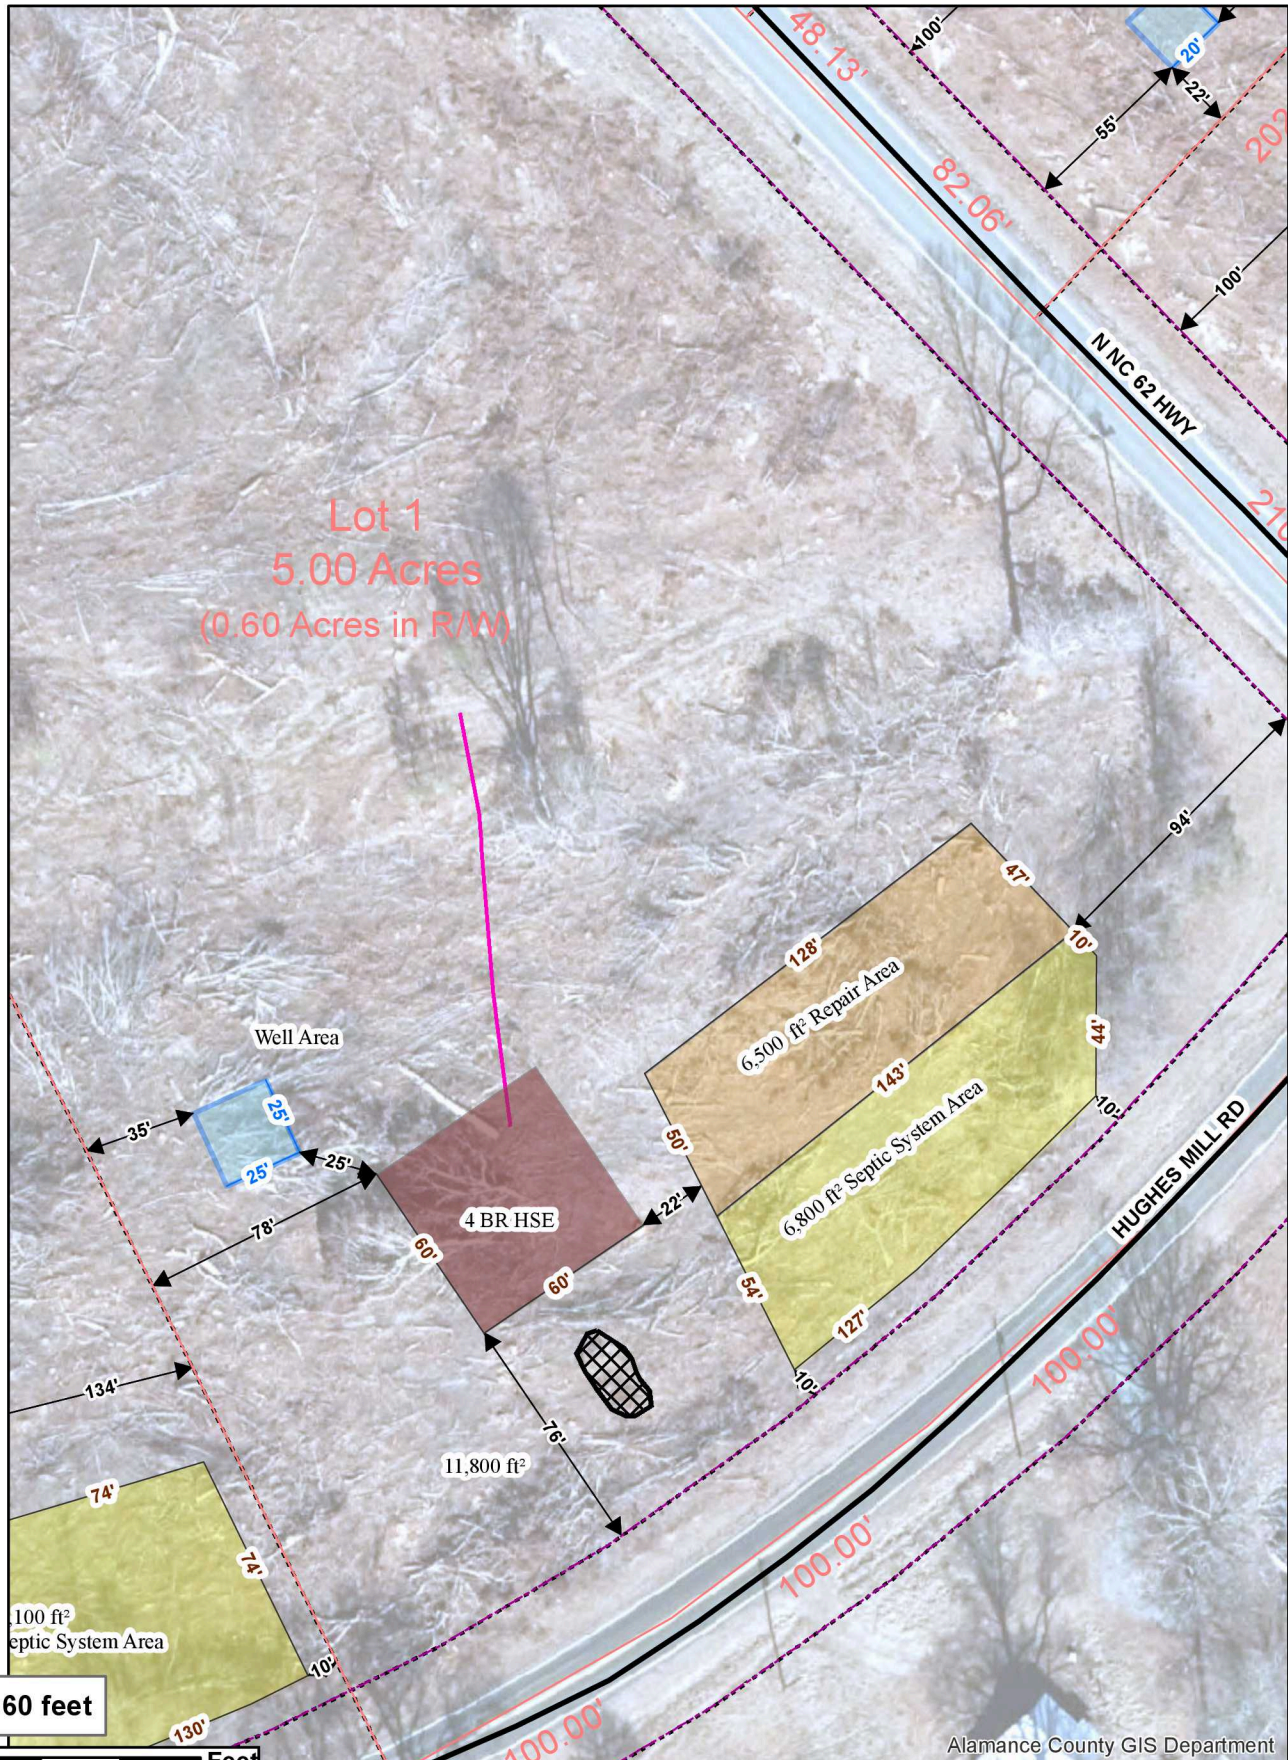

Scale is approximate and may not be accurate on emailed, scanned, and faxed copies of this drawing.

**Date Printed: 3/27/2023**

This Map is the best representation of field data based on information supplied to ACHD and is accurate within the limits of our equipment.  
This is not a survey map. Property Lines must be clearly marked in the field by the property owner prior to work on the well and septic system.