



Environmental Health Section
Alamance County Health Department
(336) 570-6367

Name: J Carter Tax Map #: 11-3-53
 Subdivision: Uplands Southeast Lot#: 8
 IP: X AWC: X OP:
 EHS: RES Date: 3/13/2023 WELL: X

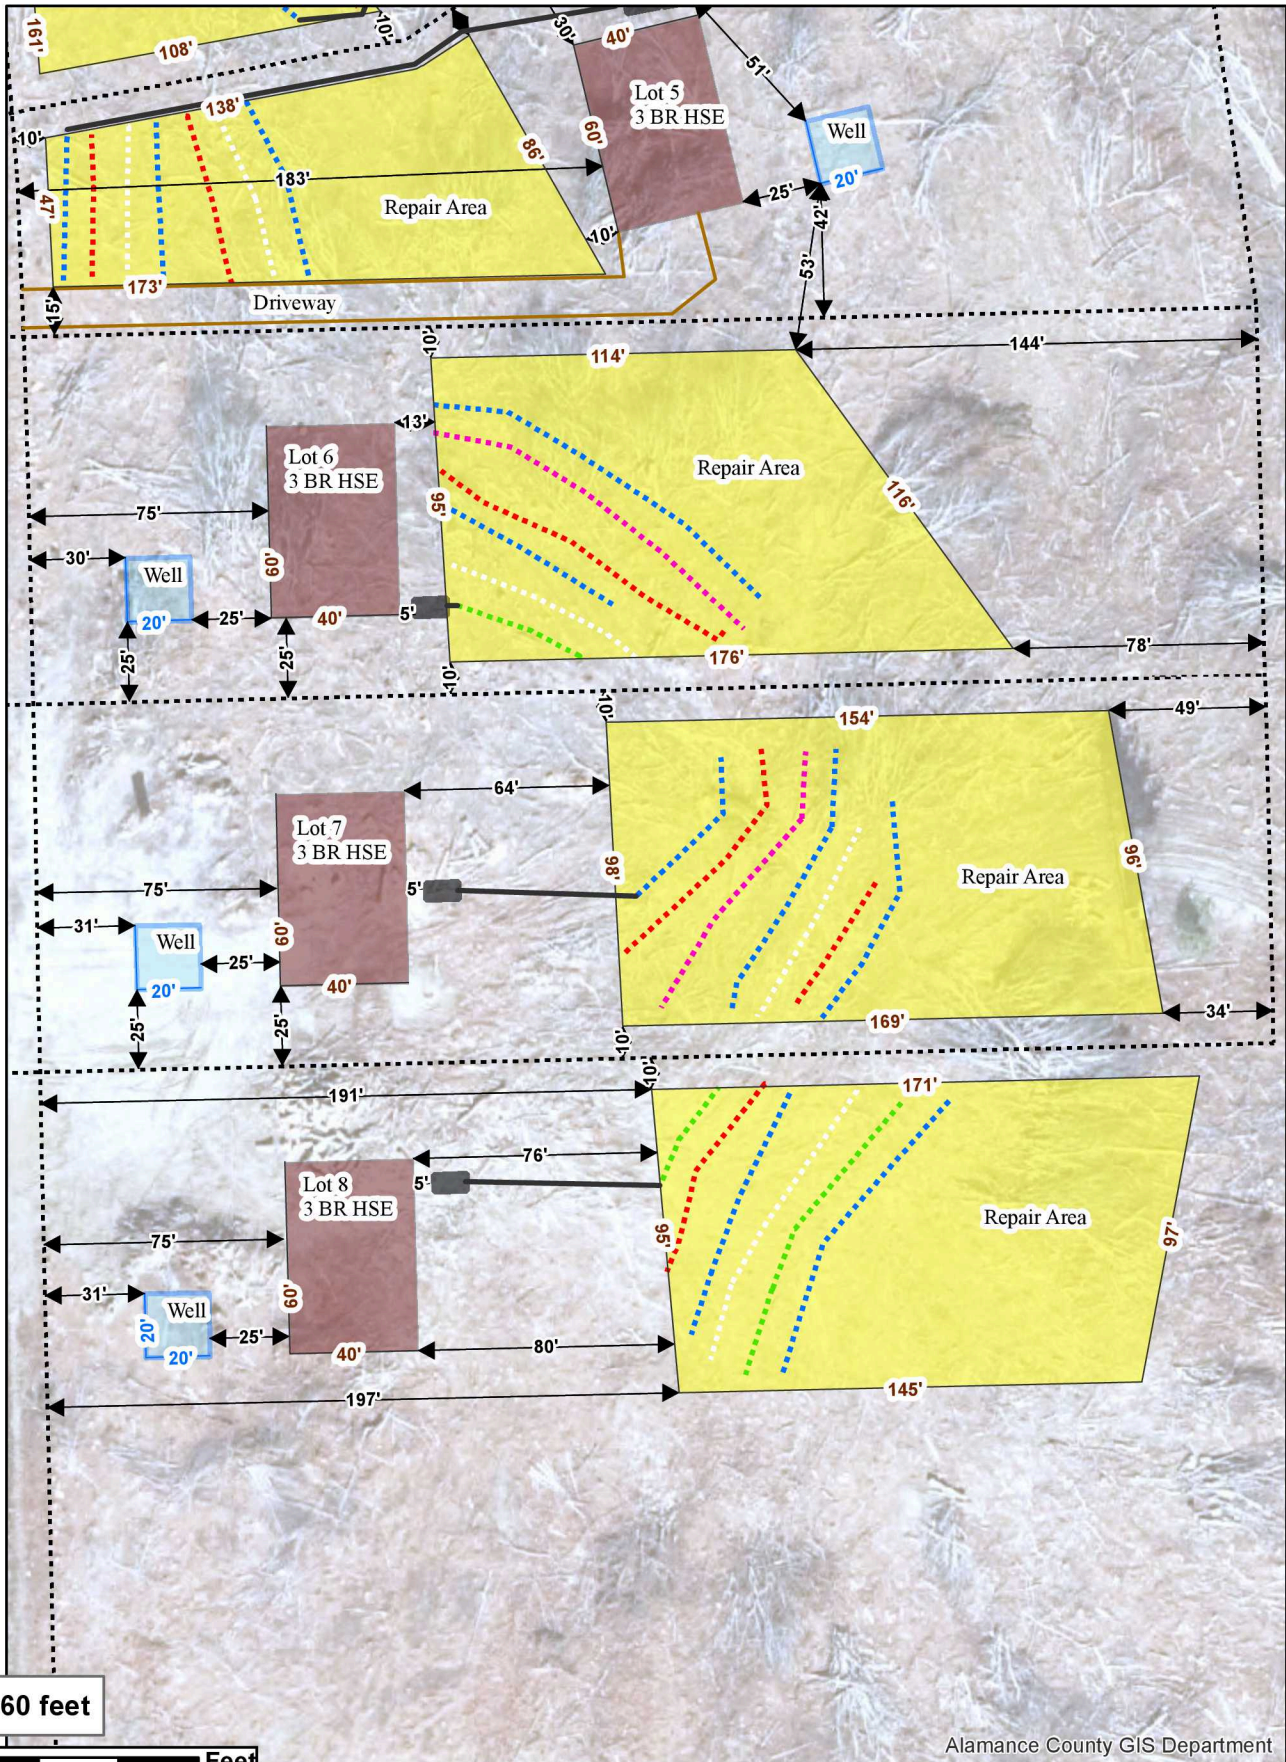

1 inch = 60 feet

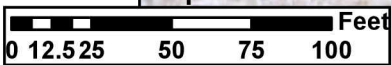

Scale is approximate and may not be accurate on emailed, scanned, and faxed copies of this drawing.

Date Printed: 3/13/2023

This Map is the best representation of field data based on information supplied to ACHD and is accurate within the limits of our equipment. This is not a survey map. Property Lines must be clearly marked in the field by the property owner prior to work on the well and septic system.