

CASWELL COUNTY ENVIRONMENTAL HEALTH


**144 MAIN STREET, P.O. BOX 1406, YANCEYVILLE, NC 27379/ (336) 694-9731, FAX (336) 694-5547
IMPROVEMENT PERMIT**

ISSUED TO:	DAVID SHANKLIN	PIN	0130 002	PERMIT NUMBER:	3344
-------------------	----------------	------------	----------	-----------------------	------

Section I: Improvement Permit (A Building Permit Cannot Be Issued With Only An Improvement Permit)

IP		Property Location:	0 GRIER'S CHURCH RD, LEASBURG, NC
Type of Structure: SFD 3BR			
Number of Bedrooms:	03	Basement:	Pump Required: NO
Number of Occupants:	6	Pump May Be Required Based Upon Final Location and Elevations of Facilities.	
Type of Water Supply:		Water Shed:	
Projected Daily Flow (GPD):	360gpd	<i>Permit Valid For: Five Years</i>	
Type of Wastewater System:	ILA		
Site Improvements Required Prior To Construction Authorization Issuance:			
Permit Conditions:			


Authorized State Agent:




Date: 02/09/2024

SEE ATTACHED SITE SKETCH

The issuance of this permit by the Health Department in no way guarantees the issuance of other permits. The permit holder is responsible for checking with appropriate governing bodies in meeting their requirements. This permit is subject to revocation if the site plan, plat, or the intended use changes. The Improvement Permit shall not be affected by a change in ownership of the site. This permit is subject to compliance with the provisions of the Laws and Rules for Sewage Treatment and Disposal and to conditions of this permit.

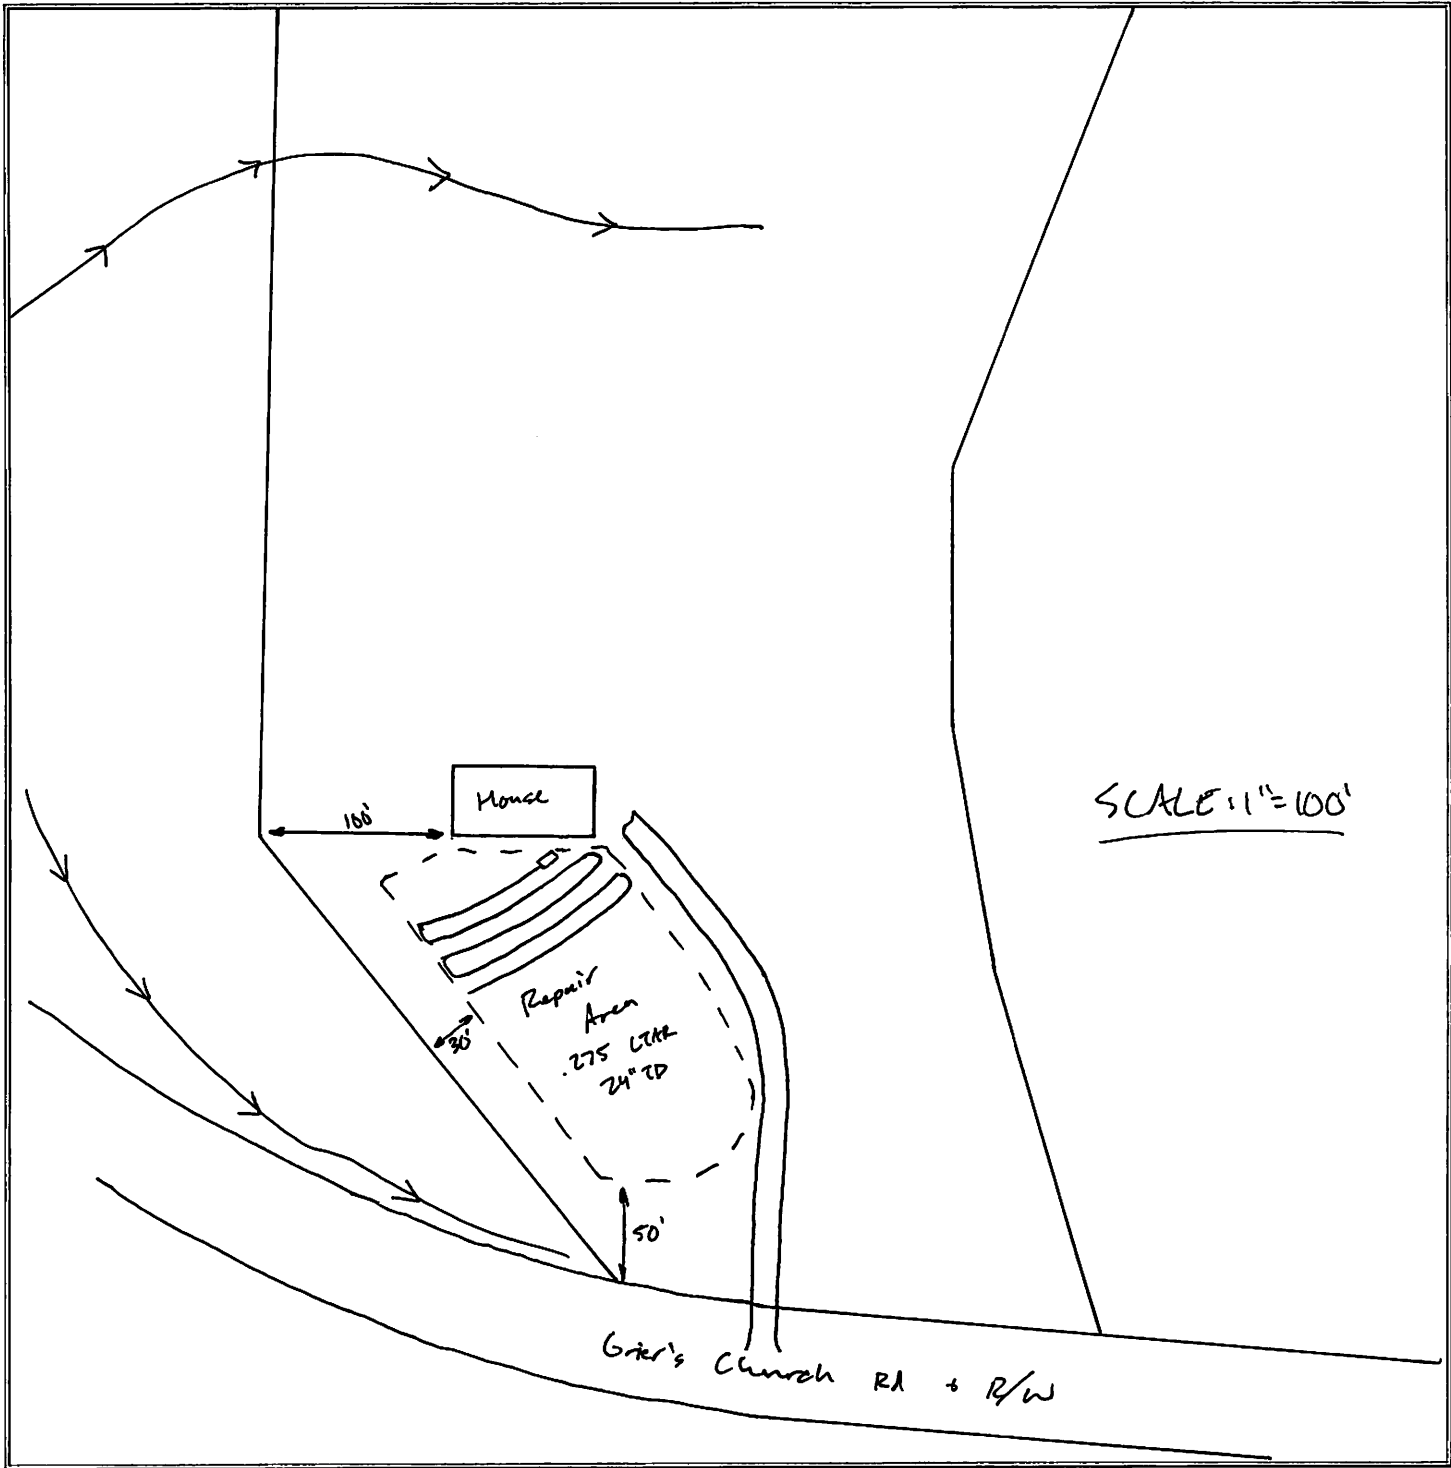

SCALE 1"=100'

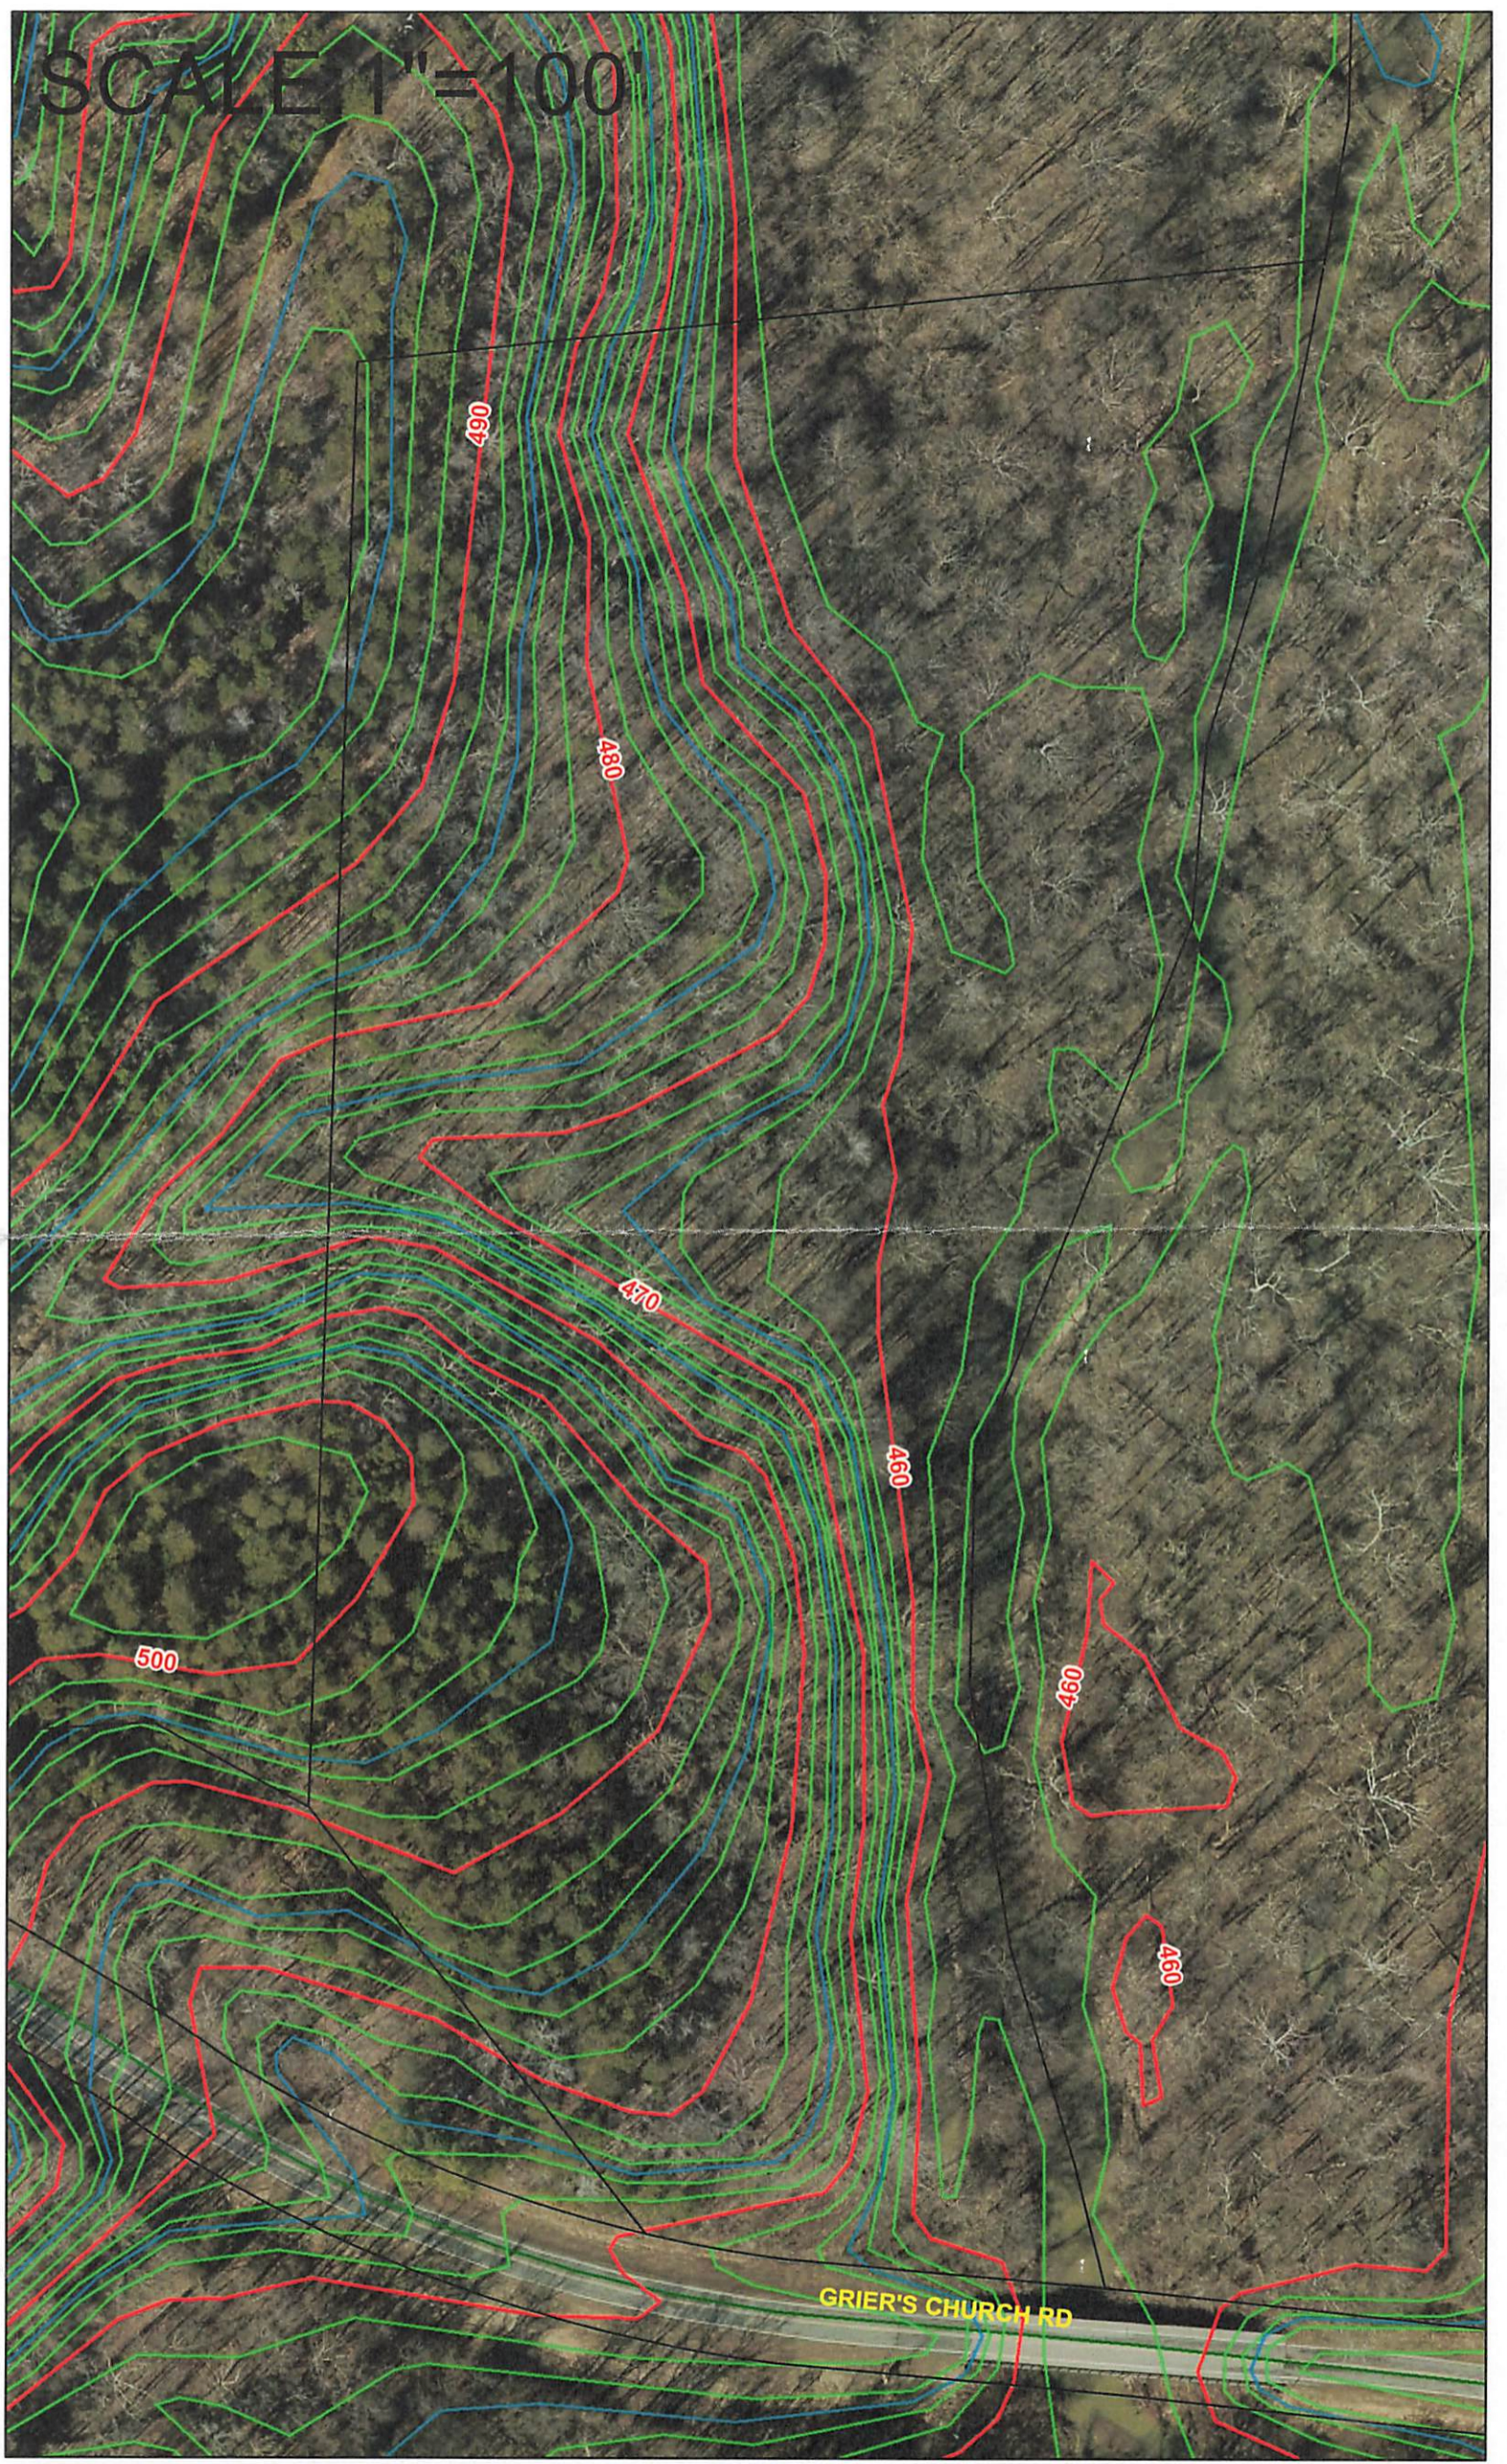

490

480

470

460

500

460

460

GRIER'S CHURCH RD