

Pasquotank-Perquimans-Camden-Chowan District Health Department


REFERENCE NUMBER: 14466 Alternative IMPROVEMENT	DATE: 12/29/97	PARCEL IDENTIFIER: 7993-504688(3)	COUNTY: PASQUOTANK
REQUESTER: WINSLOW, HENRY 2008 ASBURY DR ELIZABETH CITY, NC 27909 TELEPHONE: 335-7683	OWNER: Edwin Cordero WINSLOW, HENRY 225 Poplar Dr ELIZABETH CITY, NC 27909 335-7683 E.C.		
LOCATION/DIRECTIONS: LOT BESIDE BRADYS OUTDOOR EQUIPMENT 1334 US17 South, Eddie's Auto			
3RD LOT OF 3 LOTS NEXT TO LITTLE HOUSE BESIDE BRADYS OUTDOOR EQUIPMENT			
FE: 150.00 Bill 18325	WATER: PUBLIC	SEWER: PRIVATE	REMARKS:

PERMIT SHALL BE VALID FOR 60 MONTHS FROM DATE OF ISSUE.

is permit is NOT to be used for installation unless accompanied by a valid Authorization for Wastewater System Construction.

Bedrms 3 Disposal 0 # People _____ Type Bld R
Size Tank 1000 Line Len 80' # lines 4 Width Bot 3
Backfill 4.50 ft

PERMIT IS SUBJECT TO REVOCATION IF SITE PLANS OR THE INTENDED USE CHANGES.

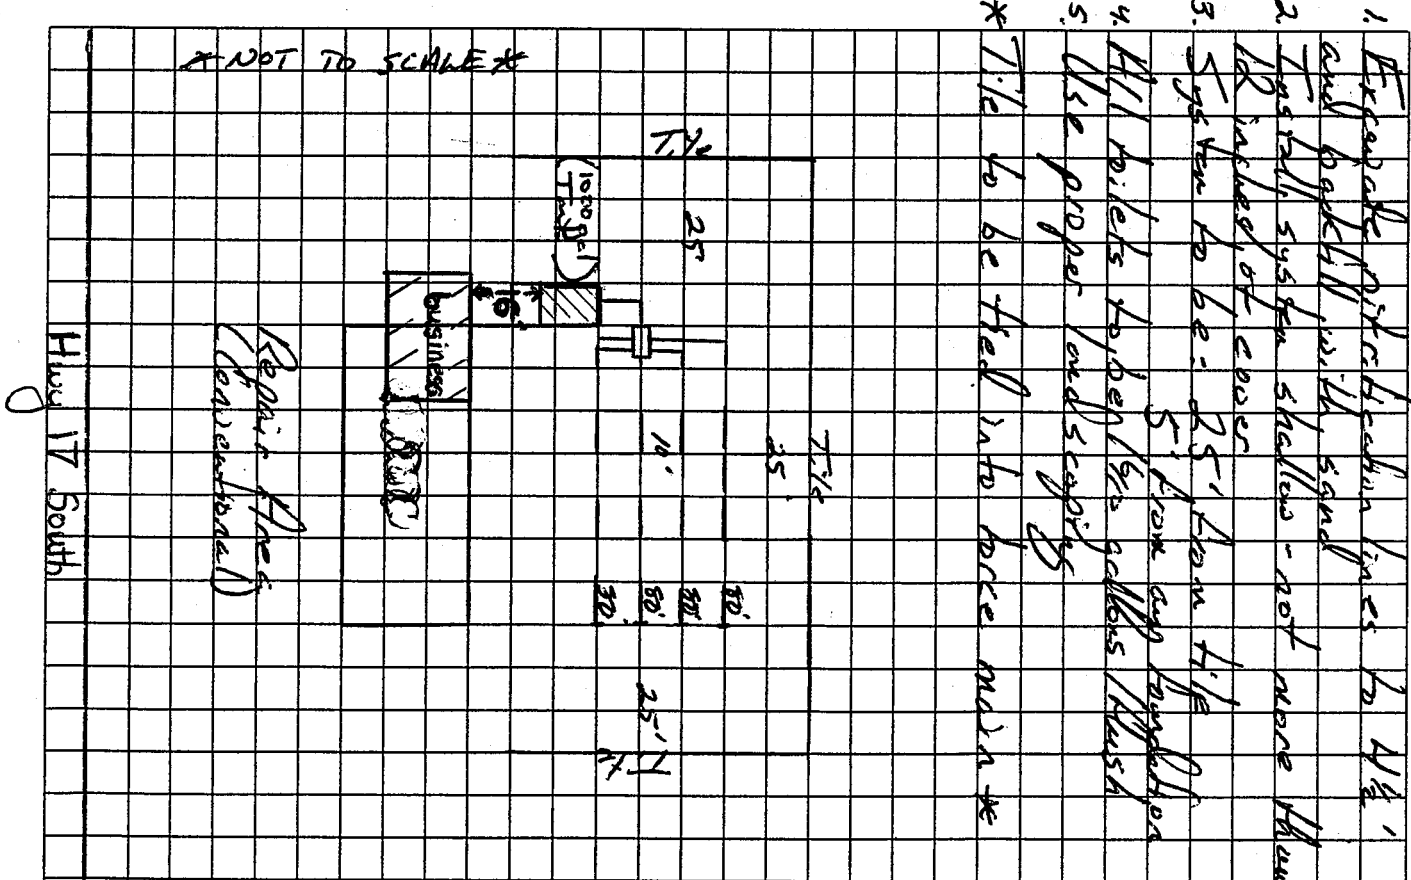

PASQUOTANK-PERQUIMANS-CAMDEN-CHOWAN DISTRICT HEALTH DEPARTMENT COPY

Date Issued: 01/12/98

Sanitarian: RALPH HOLLOWEL

Date Approved: 2/11/98

Signature

Ralph W. Hollowel R.S.
Operation Permit